

Situace

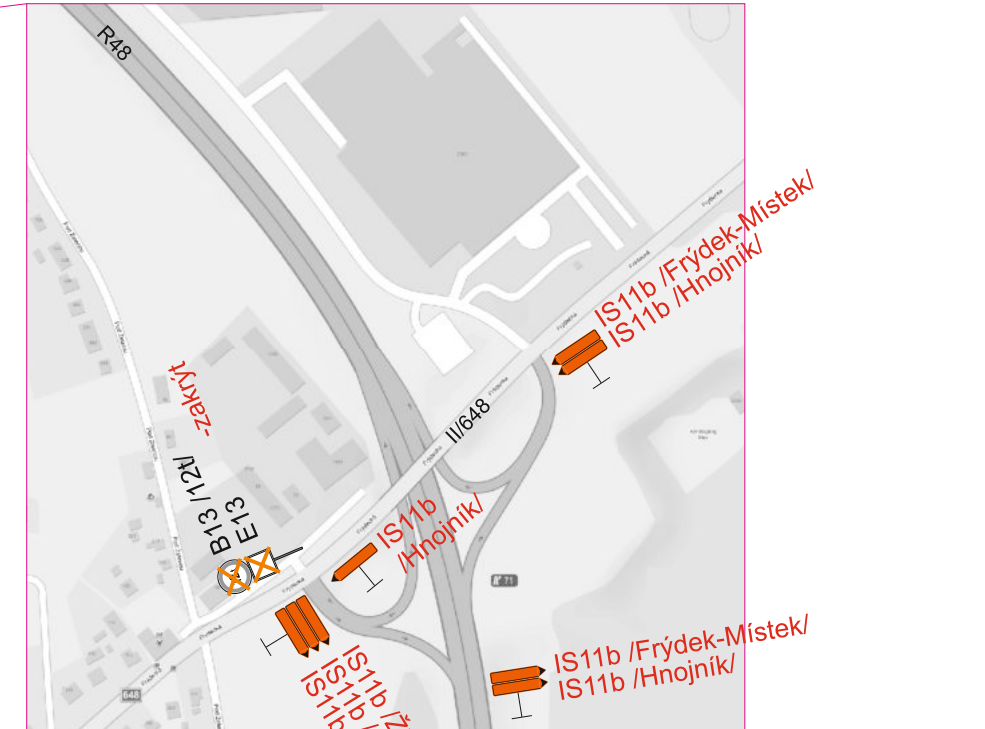
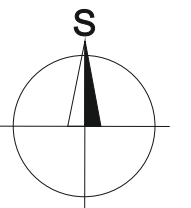
Map showing the layout of the IS11b and IS11a radar stations in the Opava region. The map includes the city of Opava, the Svitava river, and the surrounding areas. The radar stations are marked with orange rectangles and labeled with their names and coordinates. The map also shows the road network, including the D48 and R11 roads. The legend indicates that the orange rectangles represent the radar stations and the red lines represent the radar beams.

Legend:

- Orange rectangle: Radar station
- Red line: Radar beam

Map Labels:

- IS11b / Žilina
- IS11b / Jablunkov
- IS11b / Trinec
- IS11b / Hnojník
- IS11b / Frýdek-Místek
- IS11b / Ostrava
- IS11a
- IP10a
- IP10b
- IP10c
- IP10d
- IP10e
- IP10f
- IP10g
- IP10h
- IP10i
- IP10j
- IP10k
- IP10l
- IP10m
- IP10n
- IP10o
- IP10p
- IP10q
- IP10r
- IP10s
- IP10t
- IP10u
- IP10v
- IP10w
- IP10x
- IP10y
- IP10z
- IP10aa
- IP10ab
- IP10ac
- IP10ad
- IP10ae
- IP10af
- IP10ag
- IP10ah
- IP10ai
- IP10aj
- IP10ak
- IP10al
- IP10am
- IP10an
- IP10ao
- IP10ap
- IP10aq
- IP10ar
- IP10as
- IP10at
- IP10au
- IP10av
- IP10aw
- IP10ax
- IP10ay
- IP10az
- IP10ba
- IP10bb
- IP10bc
- IP10bd
- IP10be
- IP10bf
- IP10bg
- IP10bh
- IP10bi
- IP10bj
- IP10bk
- IP10bl
- IP10bm
- IP10bn
- IP10bo
- IP10bp
- IP10bq
- IP10br
- IP10bs
- IP10bt
- IP10bu
- IP10bv
- IP10bw
- IP10bx
- IP10by
- IP10bz
- IP10ca
- IP10cb
- IP10cc
- IP10cd
- IP10ce
- IP10cf
- IP10cg
- IP10ch
- IP10ci
- IP10cj
- IP10ck
- IP10cl
- IP10cm
- IP10cn
- IP10co
- IP10cp
- IP10cq
- IP10cr
- IP10cs
- IP10ct
- IP10cu
- IP10cv
- IP10cw
- IP10cx
- IP10cy
- IP10cz
- IP10da
- IP10db
- IP10dc
- IP10dd
- IP10de
- IP10df
- IP10dg
- IP10dh
- IP10di
- IP10dj
- IP10dk
- IP10dl
- IP10dm
- IP10dn
- IP10do
- IP10dp
- IP10dq
- IP10dr
- IP10ds
- IP10dt
- IP10du
- IP10dv
- IP10dw
- IP10dx
- IP10dy
- IP10dz
- IP10ea
- IP10eb
- IP10ec
- IP10ed
- IP10ee
- IP10ef
- IP10eg
- IP10eh
- IP10ei
- IP10ej
- IP10ek
- IP10el
- IP10em
- IP10en
- IP10eo
- IP10ep
- IP10eq
- IP10er
- IP10es
- IP10et
- IP10eu
- IP10ev
- IP10ew
- IP10ex
- IP10ey
- IP10ez
- IP10fa
- IP10fb
- IP10fc
- IP10fd
- IP10fe
- IP10ff
- IP10fg
- IP10fh
- IP10fi
- IP10fj
- IP10fk
- IP10fl
- IP10fm
- IP10fn
- IP10fo
- IP10fp
- IP10fq
- IP10fr
- IP10fs
- IP10ft
- IP10fu
- IP10fv
- IP10fw
- IP10fx
- IP10fy
- IP10fz
- IP10ga
- IP10gb
- IP10gc
- IP10gd
- IP10ge
- IP10gf
- IP10gg
- IP10gh
- IP10gi
- IP10gj
- IP10gk
- IP10gl
- IP10gm
- IP10gn
- IP10go
- IP10gp
- IP10gq
- IP10gr
- IP10gs
- IP10gt
- IP10gu
- IP10gv
- IP10gw
- IP10gx
- IP10gy
- IP10gz
- IP10ha
- IP10hb
- IP10hc
- IP10hd
- IP10he
- IP10hf
- IP10hg
- IP10hh
- IP10hi
- IP10hj
- IP10hk
- IP10hl
- IP10hm
- IP10hn
- IP10ho
- IP10hp
- IP10hq
- IP10hr
- IP10hs
- IP10ht
- IP10hu
- IP10hv
- IP10hw
- IP10hx
- IP10hy
- IP10hz
- IP10ia
- IP10ib
- IP10ic
- IP10id
- IP10ie
- IP10if
- IP10ig
- IP10ih
- IP10ii
- IP10ij
- IP10ik
- IP10il
- IP10im
- IP10in
- IP10io
- IP10ip
- IP10iq
- IP10ir
- IP10is
- IP10it
- IP10iu
- IP10iv
- IP10iw
- IP10ix
- IP10iy
- IP10iz
- IP10ja
- IP10jb
- IP10jc
- IP10jd
- IP10je
- IP10jf
- IP10jg
- IP10jh
- IP10ji
- IP10jj
- IP10jk
- IP10jl
- IP10jm
- IP10jn
- IP10jo
- IP10jp
- IP10jq
- IP10jr
- IP10js
- IP10jt
- IP10ju
- IP10jv
- IP10jw
- IP10jx
- IP10jy
- IP10jz
- IP10ka
- IP10kb
- IP10kc
- IP10kd
- IP10ke
- IP10kf
- IP10kg
- IP10kh
- IP10ki
- IP10kj
- IP10kk
- IP10kl
- IP10km
- IP10kn
- IP10ko
- IP10kp
- IP10kq
- IP10kr
- IP10ks
- IP10kt
- IP10ku
- IP10kv
- IP10kw
- IP10kx
- IP10ky
- IP10kz
- IP10la
- IP10lb
- IP10lc
- IP10ld
- IP10le
- IP10lf
- IP10lg
- IP10lh
- IP10li
- IP10lj
- IP10lk
- IP10ll
- IP10lm
- IP10ln
- IP10lo
- IP10lp
- IP10lq
- IP10lr
- IP10ls
- IP10lt
- IP10lu
- IP10lv
- IP10lw
- IP10lx
- IP10ly
- IP10lz
- IP10ma
- IP10mb
- IP10mc
- IP10md
- IP10me
- IP10mf
- IP10mg
- IP10mh
- IP10mi
- IP10mj
- IP10mk
- IP10ml
- IP10mm
- IP10mn
- IP10mo
- IP10mp
- IP10mq
- IP10mr
- IP10ms
- IP10mt
- IP10mu
- IP10mv
- IP10mw
- IP10mx
- IP10my
- IP10mz
- IP10na
- IP10nb
- IP10nc
- IP10nd

[illegible]

 Uzavřený žel. přejezd

Vyracoval:		Datum:		 SEKNE , spol. s r.o. Hamerská 12, 772 00 Olomouc DIČ: CZ62363701 tel./fax: 585 311 867	
Bc. Martin Bodlák		13.6.2022			
Název akce: Havarijní oprava žel. přejezdu P8330, Střítež					
Název objektu: Přechodné dopravní značení				Formát:	Č. výkresu:
Příloha: Úplná uzavírka silnice I/68				2x A4	1
				Č. soupavy:	